
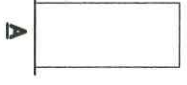
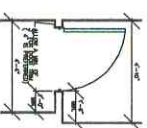


LEGEND

- F - NEW FIRE EXTINGUISHER, ANNUAL 2A RATING
- EMERGENCY LIGHTING, BATTERY PACK
- EMERGENCY LIGHTING, ROUTE HEAD
- EXIST - EXIST. SIGN
- NEW WALL CONSTRUCTION
- SMOKE DETECTOR
- NEW ALARM MANUAL PULL STATION
- EXIST. SPRINKLER HEAD

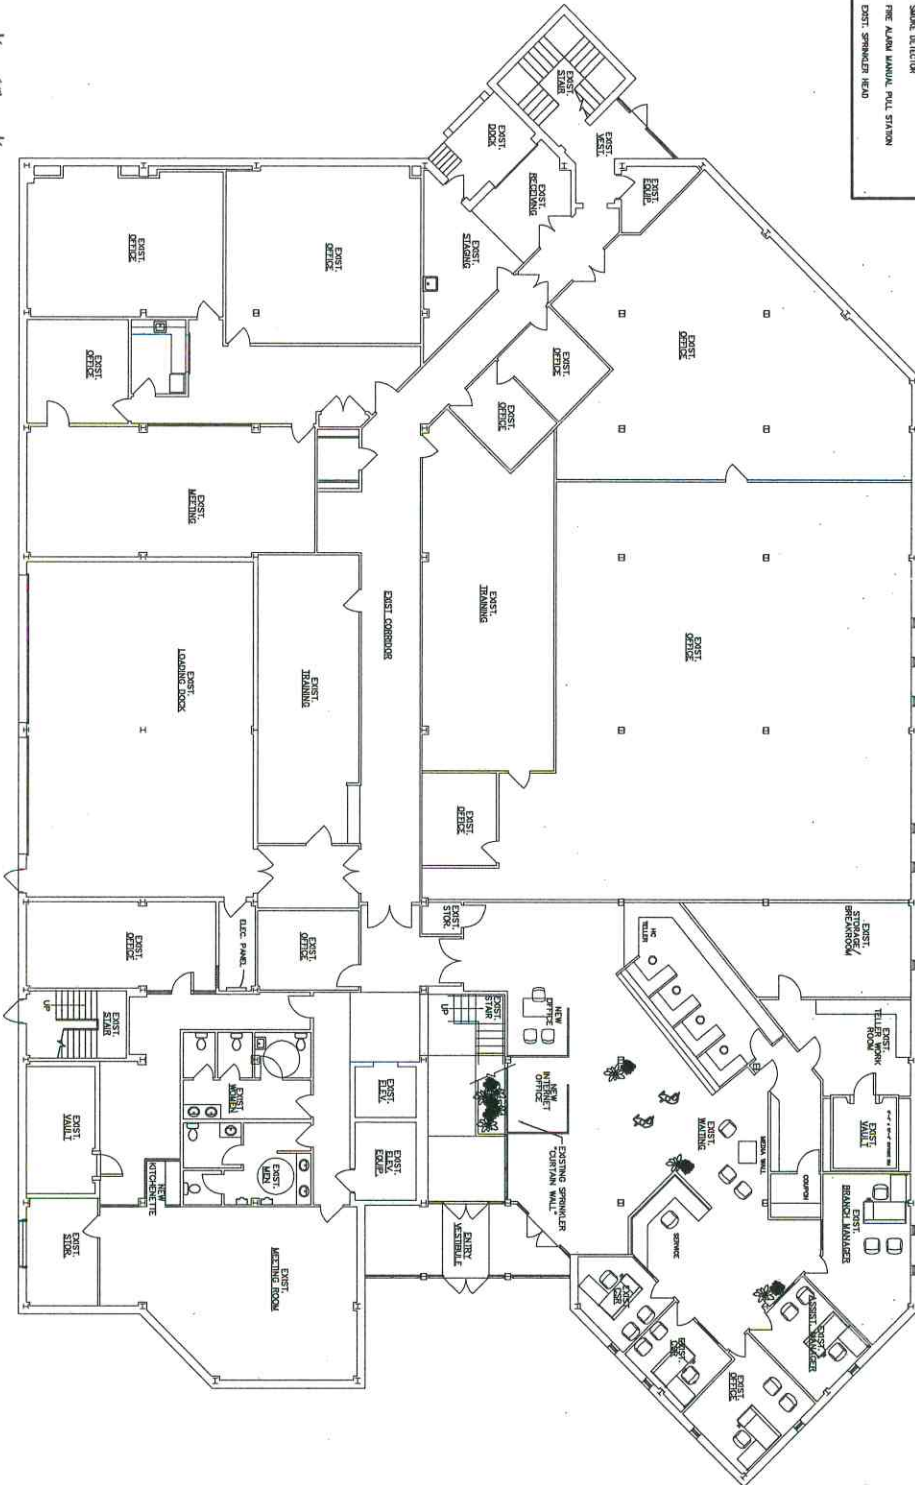

AS BUILT FIRST FLOOR PLAN

PREVIOUS I & I APPROVAL
 TEL: 717-333-8888
 FAX: 717-333-8888

DISCLAIMER
 This document is the property of Larson Design Group, Inc. and is to be used only for the project and location specified herein. It is not to be reproduced, stored in a retrieval system, or transmitted in any form or by any means, electronic, mechanical, photocopying, recording, or by any information storage and retrieval system, without the prior written permission of Larson Design Group, Inc. The user of this document is advised that it is not to be used for any other purpose, and that the user is responsible for obtaining all necessary permits and approvals for the project and location specified herein.

PROJECT NO. 1
M4
 500-003

PROPOSED FIRST FLOOR PLAN
BRANCH BANK RENOVATIONS
 FOR
C + N BANK
 130 COURT STREET, WILLIAMSPORT, PA 17701



LDG ARCHITECTS • ENGINEERS • SURVEYORS
 DESIGN GROUP
 1000 COMMERCE PARK DRIVE
 P.O. BOX 487
 WILLIAMSPORT, PA 17703-0487
 PHONE (717) 333-8888
 FAX (717) 333-8888
 www.larsondesigngroup.com

DATE: 01/28/2014
 SCALE: AS SHOWN
 DRAWING: 1
 PROJECT: M4
 SHEET: 500-003

LOC
 130 COURT STREET, WILLIAMSPORT, PA 17701

LEGEND

- NEW FIRE EXTINGUISHER, MANUAL 2A BATTING
- EMERGENCY LIGHTING, BATTERY PACK
- EMERGENCY LIGHTING, RECHARGE HEAD
- NEW WALL CONSTRUCTION
- EXIST. 20M
- SMOKE DETECTOR
- FIRE ALARM MANUAL PULL STATION
- EXIST. SPRINKLER HEAD

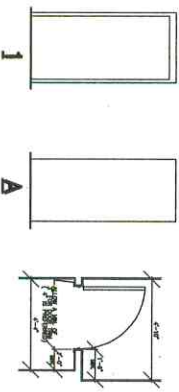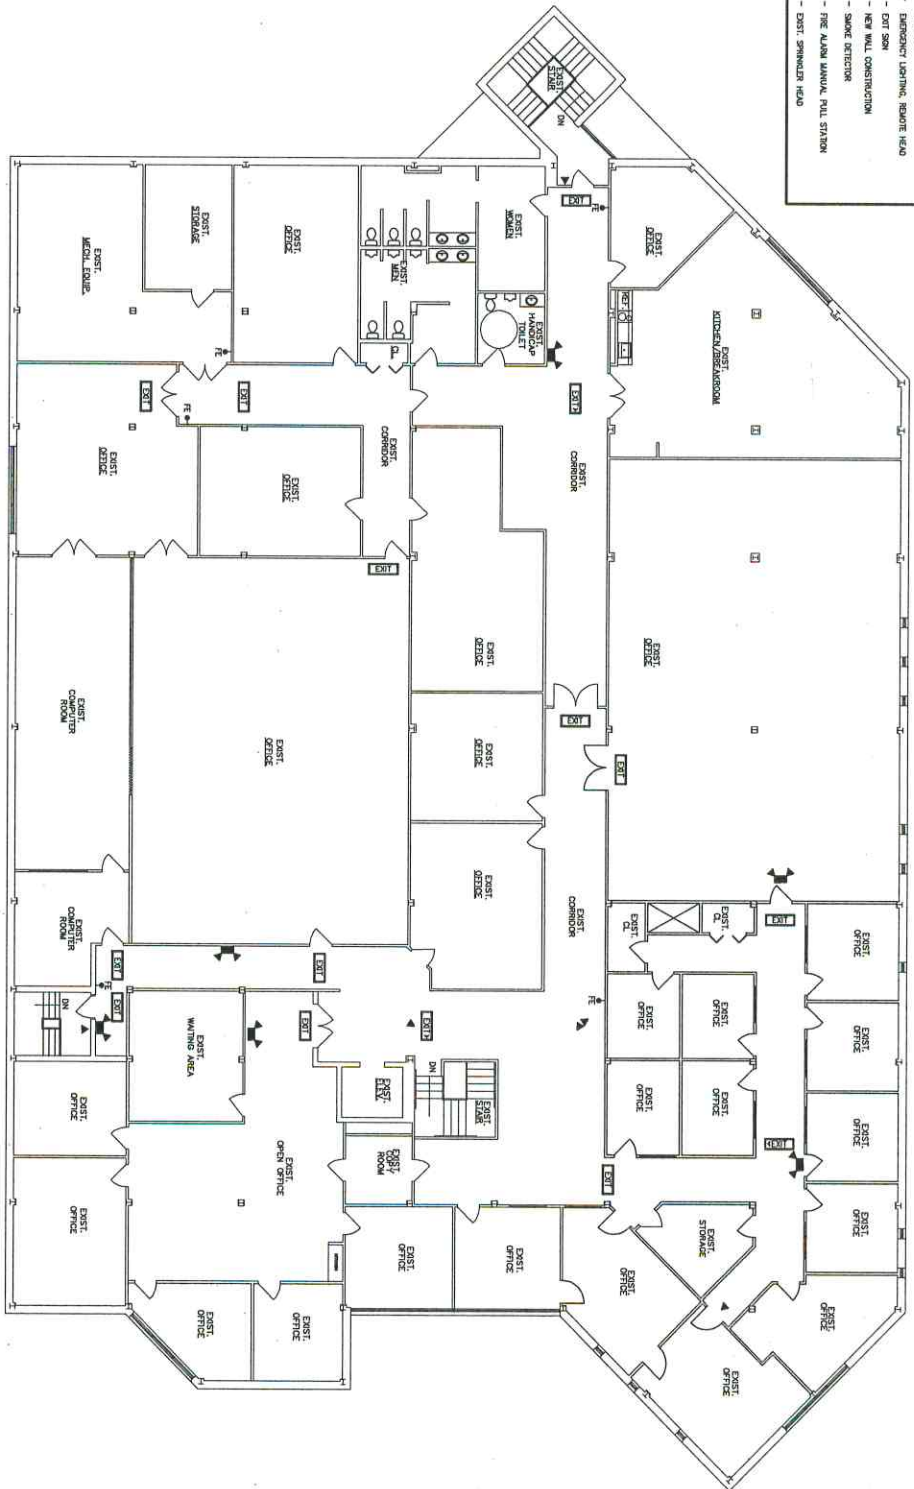

1 SECOND FLOOR PLAN

PREVIOUS L & I APPROVAL
 DATE: 06/15/2006
 ISSUE NO: 06-0444

DISCLAIMER
 THE ARCHITECT SHALL BE RESPONSIBLE FOR THE ACCURACY OF THE INFORMATION PROVIDED TO HIM BY THE CLIENT. THE ARCHITECT SHALL NOT BE RESPONSIBLE FOR THE ACCURACY OF THE INFORMATION PROVIDED TO HIM BY ANY OTHER PARTY. THE ARCHITECT SHALL NOT BE RESPONSIBLE FOR THE ACCURACY OF THE INFORMATION PROVIDED TO HIM BY ANY OTHER PARTY.

SHEET NO. 1
AS
 PROJECT NO. 0591-005

PROPOSED SECOND FLOOR PLAN
BRANCH BANK RENOVATIONS
 FOR
C + N BANK
 130 COURT STREET, WILLIAMSPORT, PA 17701

LARSON ARCHITECTS • ENGINEERS • SURVEYORS
LDG
DESIGN GROUP
 1500 COMMERCE PARK DRIVE
 P.O. BOX 487
 WILLIAMSPORT, PA 17703-0487
 PHONE (717) 323-6603
 FAX (717) 323-9902
 www.larsondesigngroup.com

DATE: 07/28/04
 SCALE: AS SHOWN
 DRAWN BY: [Name]
 CHECKED BY: [Name]
 PROJECT NO. 0591-005

THIS PLAN, SPECIFICATIONS, CONTRACT DOCUMENTS AND ALL INFORMATION CONTAINED HEREIN ARE THE PROPERTY OF LARSON DESIGN GROUP, INC. AND ARE NOT TO BE REPRODUCED, COPIED, OR TRANSMITTED IN ANY FORM OR BY ANY MEANS, ELECTRONIC OR MECHANICAL, INCLUDING PHOTOCOPYING, RECORDING, OR BY ANY INFORMATION STORAGE AND RETRIEVAL SYSTEM, WITHOUT THE WRITTEN PERMISSION OF LARSON DESIGN GROUP, INC.